




MADISON METROPOLITAN SEWERAGE DISTRICT ELEVENTH ADDITION TO THE NINE SPRINGS WWTP MADISON, WISCONSIN		NO.	DATE	RECORD DRAWINGS REVISIONS AND RECORD OF ISSUE	BY	APPROVED
KEY PLAN GENERAL MISCELLANEOUS SITE MODIFICATIONS		DEC 2014				
VERIFY SCALES LENGTH OF BAG (5') LENGTH OF BAG (5') ON ORIGINAL DRAWING						
PLOT SCALE 1" = 100' SCALE(S) ACCORDINGLY						
DESIGNED BY: W.A.E.						
DRAWN BY: P.C.G.						
CHECKED BY: P.A.T.						
APPROVED BY: W.A.E.						
PROJECT NO.		4635				
DATE		OCT 2011				
DRAWING NO.		88-G-1				

REHABILITATION NOTES.

- 1 FOR WORK IN AERATION CONTROL BUILDING, SEE DWG 88-R-1 AND 88-ME-1.
- 2 FOR WORK IN DEWATERING BUILDING, SEE DWG 88-M-2.
- 3 FOR WORK IN AERATION TANKS NOS. 17 & 18, SEE DWG 88-R-2, 88-M-3 AND 88-M-4.
- 4 FOR WORK IN AERATION TANKS NOS. 17 & 18, SEE DWG 88-R-2, 88-M-3 AND 88-M-4.
- 5 FOR WORK IN EAST BLOWER BUILDING, SEE DWG 88-M-6.
- 6 FOR WORK IN STORAGE BUILDING NO. 2, SEE DWG 88-P-1.
- 7 FOR WORK IN VEHICLE LOADING BUILDING, SEE DWG 88-E-1.
- 8 FOR WORK IN DAF BUILDING, SEE DWG 88-E-2.

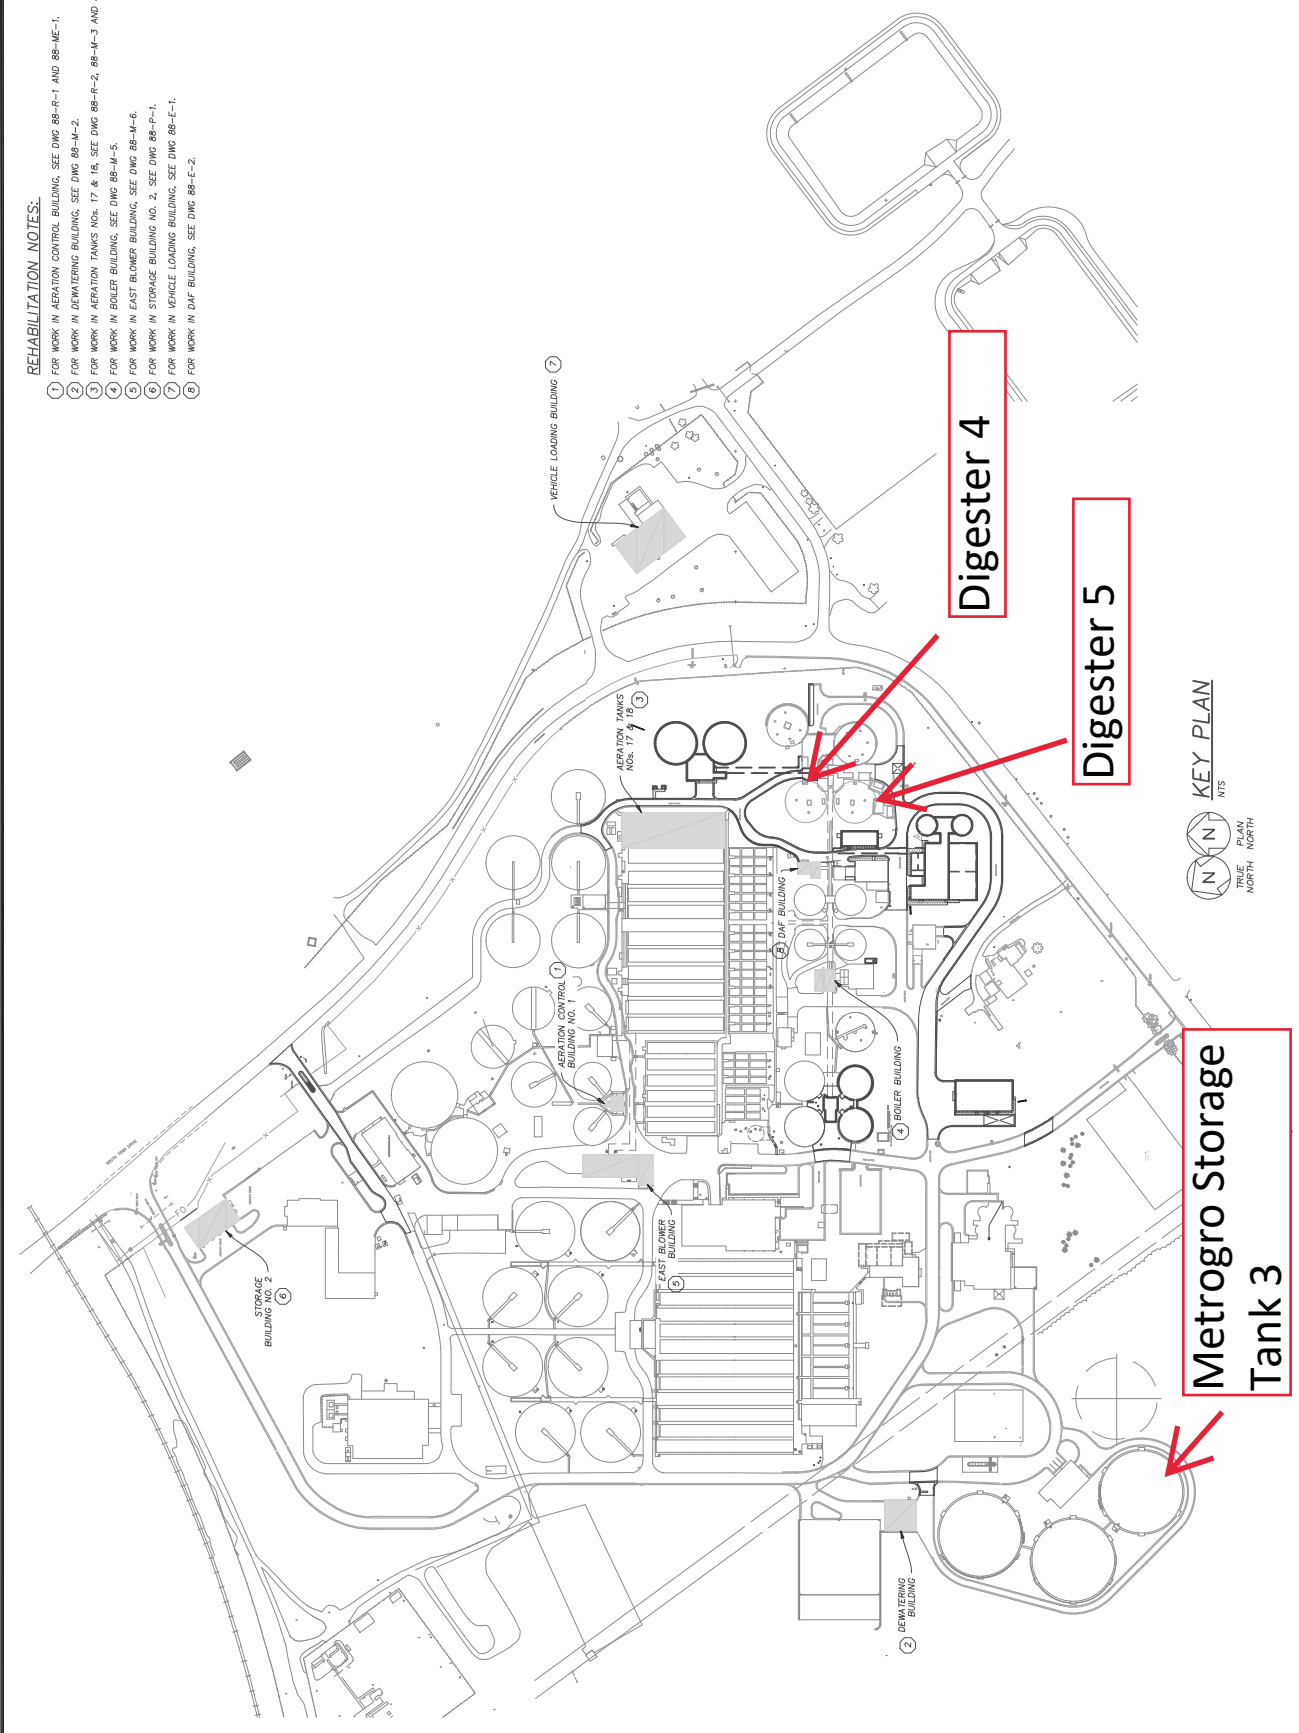


Metrogro Storage
Tank 3

Digester 5

Digester 4

KEY PLAN
N
TRUE PLAN
NORTH

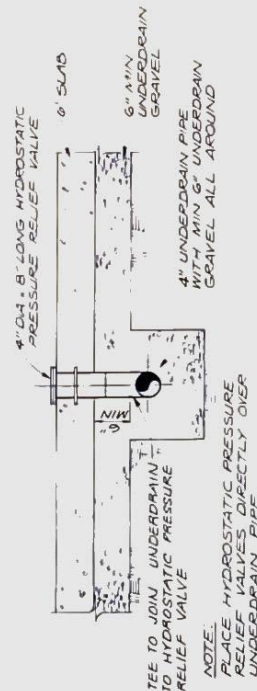

HYDROSTATIC PRESSURE RELIEF VALVE








Digesters 4 & 5



5 SEE STANDARD FOUNDATION DETAILS SHEET F-S-110
F-S-5

	DCS	SM/F			<p>THESE RECORD DRAWINGS HAVE BEEN PREPARED IN PART, ON THE BASIS OF INFORMATION COMPILED BY OTHERS. THE ENGINEER HAS NOT CONDUCTED A VISUAL CHECK OF THE TYPE OF COMPONENT NOR MANNER OF CONSTRUCTION. THE ENGINEER WILL NOT BE RESPONSIBLE FOR ANY ERRORS, OR OMISSIONS WHICH HAVE BEEN INCORPORATED INTO THE RECORD DRAWINGS.</p>	<p>0 1 2 3 4 5 6 7 8 9 10 metres</p>	<p>RECORD DRAWINGS</p> <p>Revisions Drawn by <u>DAK</u> Date <u>12/82</u></p>	<p>MAU1: MET+ QU1TAI "W, LALET "RICT M.D., " WI 45IN</p>	<p>SOUTH ADDITION TO NINE SPRINGS WASTEWATER TREATMENT PLANT EAST DIGESTER CONVEYER STRUCTURAL</p>	SHEET 142 OF 280	DS 15
	DR	DLA									
	CHK	ALM									
	APPD	KVL	NO	DATE						BY	APPD
REVISION											

DETAIL 7
N.T.S. 40-SM-1

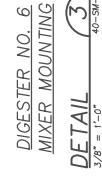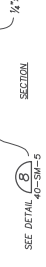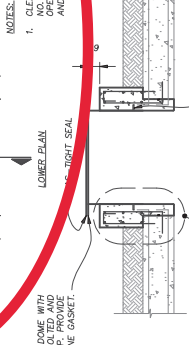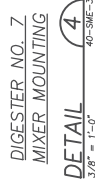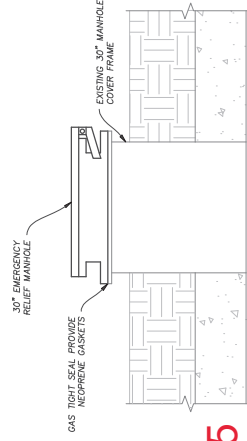

2. CONCLUDE THE CONDUCT OF THE JURY TRIAL BY:


1. CONTRACTOR SHALL VERIFY ALL DIMENSIONS AND CONDITIONS RELATED TO EXISTING CONSTRUCTION AND MAKE MINOR ADJUSTMENTS AS REQUIRED. REPORT SIGNIFICANT VARIATIONS TO ENGINEER.
2. SCHEDULE ALL CONSTRUCTION AND TEMPORARY FACILITIES WITH ENGINEER AND OWNER.
3. CONTRACTOR TO COORDINATE INSTALLATION OF ALL EQUIPMENT IN EXISTING PORTS AND HATCHES WITH EQUIPMENT MANUFACTURERS.

DETAIL 5
3/8" = 1'-0"
40-SM-1
40-SM-2
40-SME-3

ACCESS MATCH

DIGESTER NO. 6
MIXER MOUNTING

DETAIL 3 40-SM-
3/8" = 1'-0"

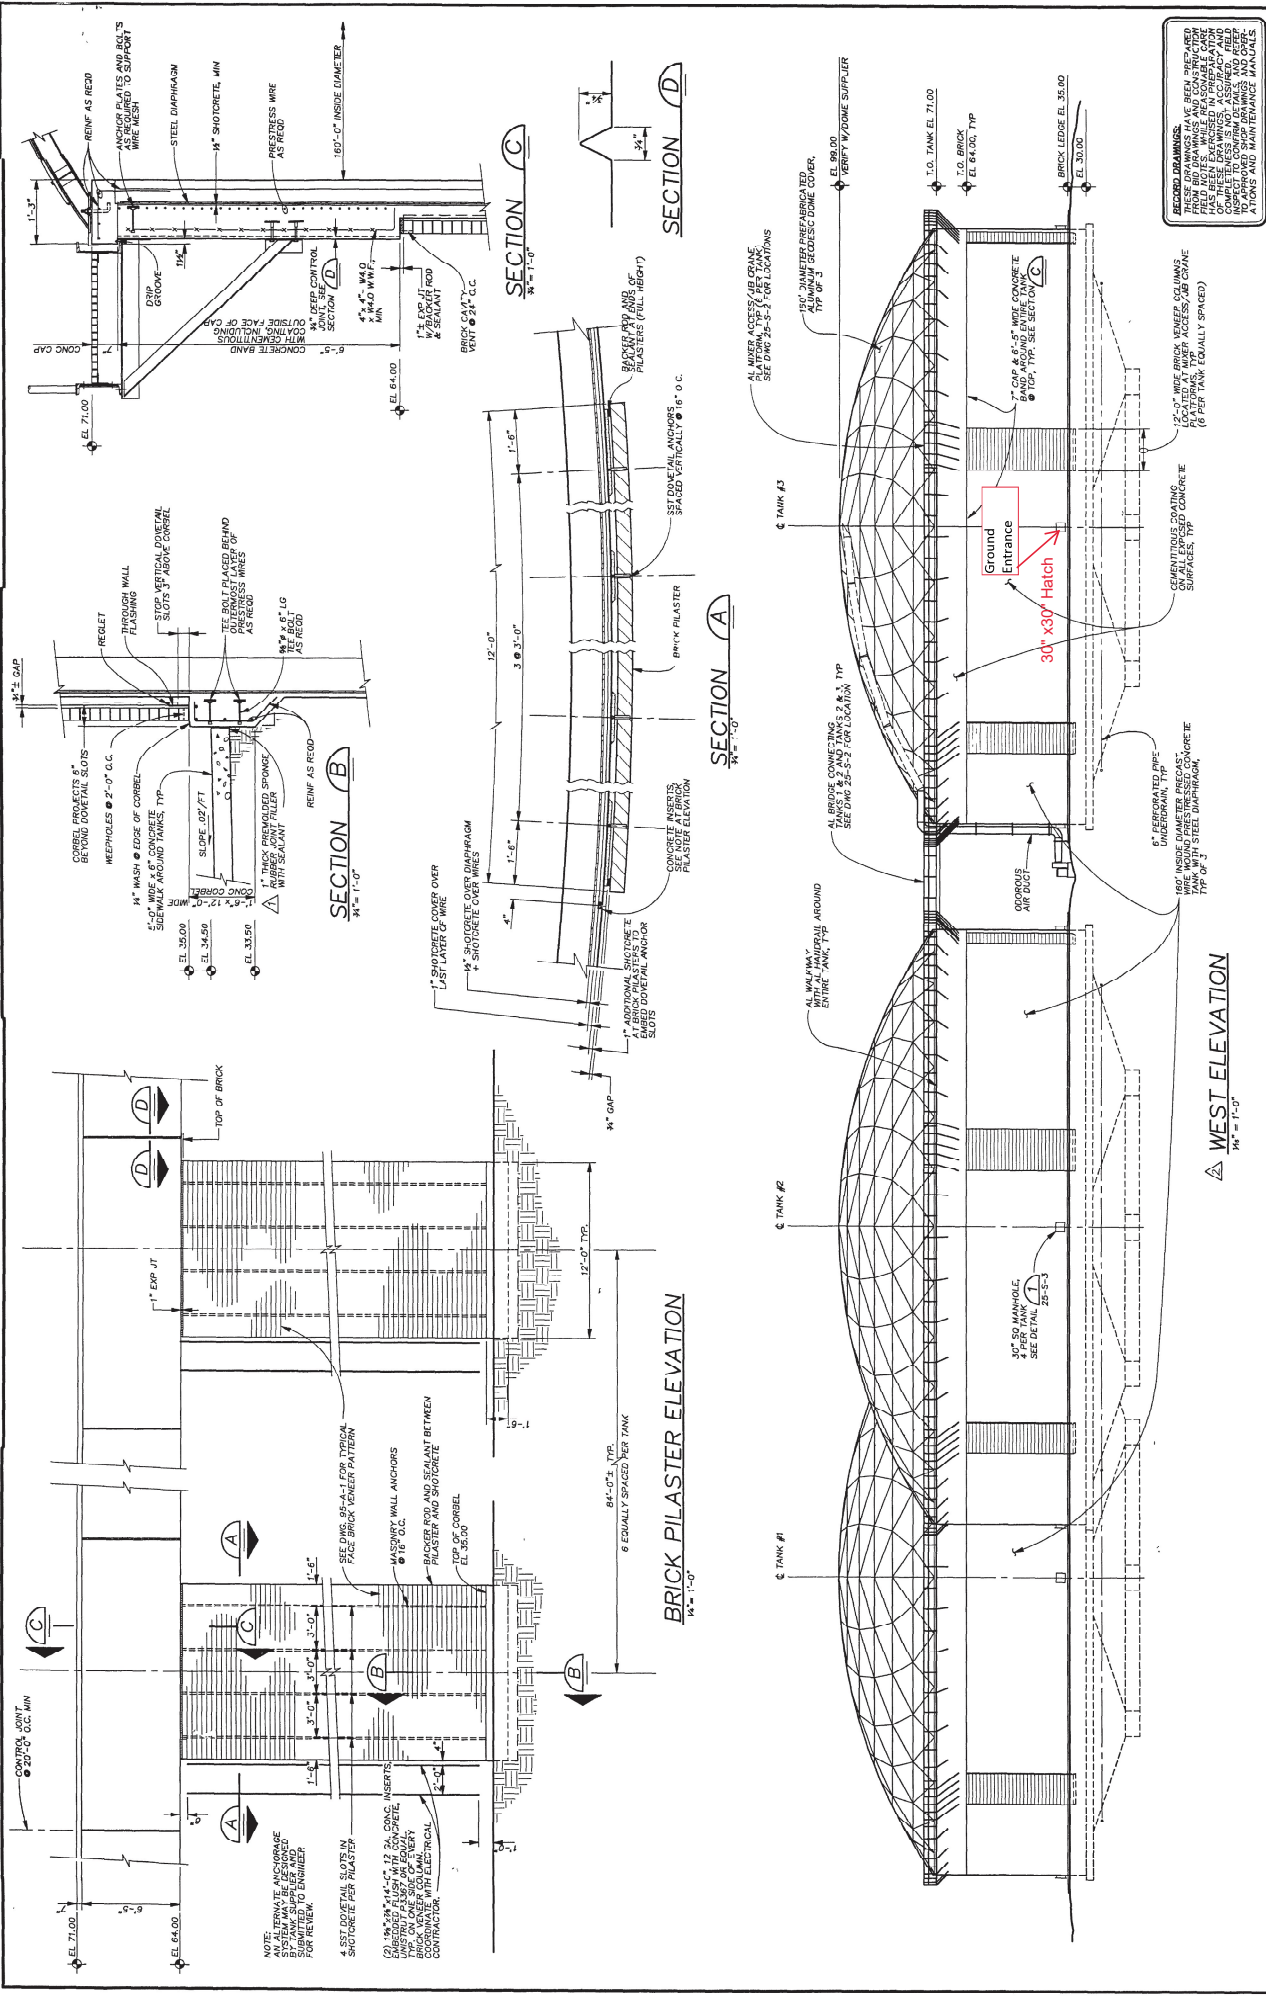


DESIGNED BY	J.J.S.	RECORD DRAWINGS	MAY 1994	NO.	DATE	REVISION	BT	APPROVED BY	J.J.S.
DRAWN BY	W.M.N.	LENGTH OF DRAWING	3-27-92	ADJUDICATOR NO. 1	DATE	REVISION	BT	APPROVED BY	J.J.S.
CHECKED BY	R.C.L.	IF DRAWING IS NOT TO BE SUBMITTED TO THE ENGINEER	3-27-92	ADJUDICATOR NO. 1	DATE	REVISION	BT	APPROVED BY	J.J.S.
APPROVED BY	J.J.S.	IF DRAWING IS NOT TO BE SUBMITTED TO THE ENGINEER	3-27-92	ADJUDICATOR NO. 1	DATE	REVISION	BT	APPROVED BY	J.J.S.

MADISON METROPOLITAN SEWERAGE DISTRICT
EIGHTH ADDITION TO THE NINE SPRINGS WWTP
MADISON, WISCONSIN

METROGRO STORAGE TANKS
STRUCTURAL
ELEVATIONS

PROJECT NO. 1368
DATE FEB 1992
DRAWING NO. 25-S-1

RECORD DRAWINGS
 THESE RECORD DRAWINGS HAVE BEEN PREPARED FROM THE ORIGINAL DRAWING AND THE RECORD DRAWING HAS BEEN EXAMINED IN CONFORMANCE WITH THE REQUIREMENTS OF THE RECORD DRAWING ACT. THE RECORD DRAWING IS NOT TO BE USED FOR ANY OTHER PURPOSES WITHOUT THE WRITTEN CONSENT OF THE ENGINEER.

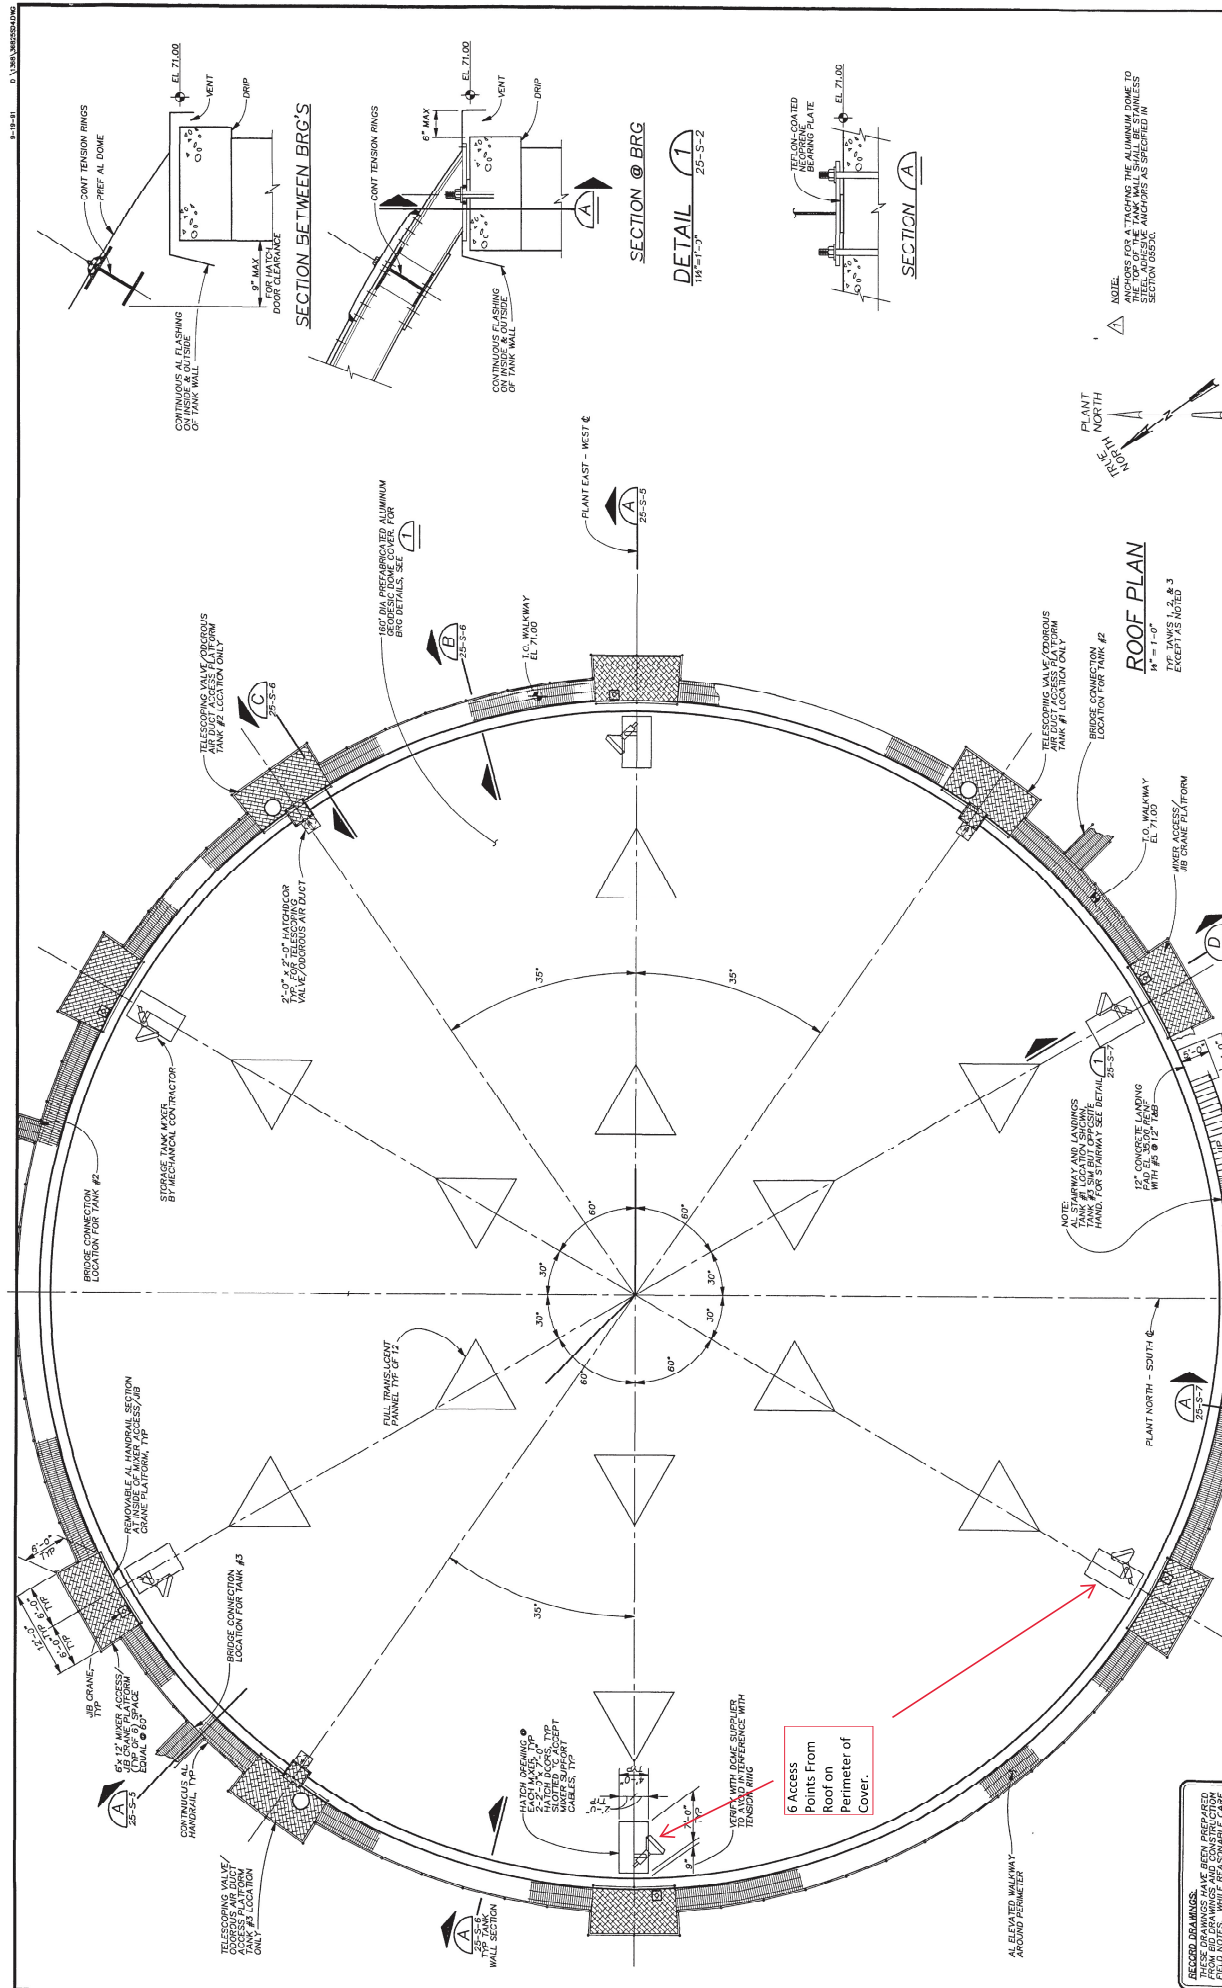

RECORD DRAWINGS. THESE DRAWINGS HAVE BEEN PREPARED FROM BID DRAWINGS AND CONSTRUCTION FIELD NOTES. WHILE REASONABLE CARE HAS BEEN EXERCISED IN PREPARATION OF THESE DRAWINGS, ACCURACY AND COMPLETENESS IS NOT ASSURED. FIELD INSPECT TO CONFIRM DETAILS, AND REFER TO APPROVED SHOP DRAWINGS AND OPERATIONS AND MAINTENANCE MANUALS.

DESIGNED BY R.C.J. DRAWN BY W.A.M. CHECKED BY J.J.S. APPROVED BY W.A.E.	VERIFY SCALES DATE: MAY 1994 BY: R.C.J. RECORD LENGTHS 3-27-92 AUGUMENT # 1 NO IF PNE IS NOT IN ON SCALE(S) ACCORDINGLY	MAY 1994 3-27-92 NO DATE	R.C.J. W.A.E. R.C.J. W.A.E. BY A.P.V.O.	Applied Technologies  	MADISON METROPOLITAN SEWERAGE DISTRICT EIGHTH ADDITION TO THE NINE SPRINGS WWTP MADISON, WISCONSIN	METROGRO STORAGE TANKS STRUCTURAL TYPICAL ROOF PLAN	PROJECT NO. 1368 DRAWING NO. 25-S-4 DATE FEB 1992
--	---	-----------------------------------	--	--	--	---	--

Madison Metropolitan Sewerage District



PRE-QUALIFICATION APPLICATION

THE CONTENTS OF THIS QUESTIONNAIRE SHALL BE CONFIDENTIAL FOR THE EXCLUSIVE USE OF THE CONTRACTING AGENCY AND SHALL NOT BE MADE PUBLIC EXCEPT BY WRITTEN PERMISSION OF THE PROSPECTIVE BIDDER.

INFORMATION / INSTRUCTIONS

- 1) To be submitted by all prime bidders. All others to submit as required by the bidding documents.
- 2) Must be received by The District prior to deadline stated in bidding documents. Additional information, if necessary, may be requested by the District.
- 3) Fill out and send questionnaire (IN PDF FORMAT) to: Prequalifications@madsewer.org
- 4) Bidder's Statement of Request for Pre-Qualification (**Green Sheet**) must be filled out for every project.
- 5) Statement of Qualifications (**Blue Sheets**) are valid for the current calendar year only.
(*EXAMPLE: project bid in June, statement of qualifications valid until 12/31*)
- 6) Submission of the Blue Sheets section of the application does not grant automatic approval for all projects advertised by the District in the current calendar year. Qualifications are still reviewed project to project by project engineer.

PREQUALIFICATION STATEMENT

There is submitted herewith for your consideration, pursuant to Section 66.0901(2), Wisconsin Statutes, a statement of qualifications of the undersigned to furnish the necessary labor, materials, and skills required to enter upon and complete contracts for Madison Metropolitan Sewerage District.

BIDDER'S STATEMENT OF REQUEST FOR PRE-QUALIFICATION

IDENTIFICATION

1. Firm's Name: _____

Mailing Address: _____

Telephone: _____

E-Mail: _____

Number of years in business under present name: _____

Is the business a: ☐ Corporation (includes LLC and S) ☐ Partnership ☐ Individual Owner

If a Corporation: Year incorporated: _____ State incorporated: _____

Contact information regarding questions related to this form:

Name: _____

Telephone Number: _____

Email Address: _____

2. The above-named Bidder requests to be pre-qualified for construction of the following project/contract:

Which do you wish to qualify as (select all that apply): ☐ Prime Contractor ☐ Subcontractor

Please specify trade(s) : _____

☐ Bidder **HAS NOT** submitted a Statement of Qualifications within the current calendar year. Documentation is required. Proceed to following page, complete forms and attach documentation.

☐ Bidder **HAS** submitted a Statement of Qualifications within the current calendar year. A new Statement of Qualifications is not required. Bidder acknowledges his/her intent to be pre-qualified for the above-named project(s) by signing and dating this form below and by returning this form to the District prior to the deadline stated in the bidding documents.

Firm Name

Signature

Title

Date

BIDDER'S STATEMENT OF QUALIFICATIONS

EXPERIENCE

I - PERSONNEL

What is the experience of the principal individuals, including officers, superintendents and/or foremen/women, of your organization? Provide information similar to the table below:

Name	Present Position/Title	Years of Experience	Description of Duties
(1)	(3)	(3)	(4)

Average number of employees during the last 12 months:

Office: _____ Skilled: _____ Unskilled: _____

II - PROJECTS COMPLETED

Provide a list of work performed on any projects pertinent to the type of work for which pre-qualification is desired. Provide information similar to the table below. Under "Capacity", state whether the work was as a Prime Contractor, Subcontractor, etc.

Year Finished	Project Name	Type of Work	Capacity	Contract Amount (\$)	Reference Name	Reference City, State	Reference Phone #	Reference Email
(1)	(2)	(3)	(4)	(5)	(6)	(7)	(8)	(9)

III - CURRENT CONTRACTS

Attach information related to current contracts. Highlight contracts that are for work similar to the type of work for which pre-qualification is desired. Provide information similar to the table below:

Project Name	Owner	% Complete	Contract Amount (\$)	Completion Date	Type of Work	Reference Name	Reference City, State	Reference Phone #	Reference Email
(1)	(2)	(3)	(4)	(5)	(6)	(7)	(8)	(9)	(10)

IV - EQUIPMENT

Provide a list of major pieces of equipment owned and available when needed for proposed work. Provide information similar to the table below:

No. of Each	Description	Model/Size	Capacity	Year
(1)	(2)	(3)	(4)	(5)

CONTRACTUAL RESPONSIBILITY

Answering "yes" to any of the following questions may not directly disqualify a company from becoming approved to bid by the District. However, *failure to answer truthfully* will likely result in disqualification.

If response is "Yes", please attach a description of particulars (date, parties involved, type of work, amount of contract, cause, resolution).

- 1) Has your firm or any officer or partner of your firm ever been debarred, suspended, disapproved, or not pre-qualified by the State of Wisconsin or any government entity in the past ten (10) years?

☐ Yes ☐ No

- 2) Has your firm or any officer or partner of your firm had any type of business, contracting, or trade license, certification, or registration revoked or suspended in the past ten (10) years?

☐ Yes ☐ No

- 3) Does your firm or any officer or partner of your firm have an open or ongoing investigation or been cited in a violation of federal, state, or local government safety or environmental laws? This includes, but is not limited to, any OSHA, EPA, or WDNR violations.

☐ Yes ☐ No

If Yes, include in description the OSHA reportable incidents and citations.

- 4) Has your firm or any officer or partner of your firm ever declared bankruptcy while performing work on a contract or work awarded to it in the past ten (10) years?

☐ Yes ☐ No

- 5) Has your firm ever defaulted on or failed to complete any contract or work awarded to it in the past ten (10) years?

☐ Yes ☐ No

- 6) Has your firm or any officer or partner of your firm asked to be relieved from a bid submitted by it to a public awarding authority in the past ten (10) years?

☐ Yes ☐ No

- 7) Has your firm or any officer or partner of your firm ever been charged with or convicted of a violation of any Davis Bacon federal wage rates?

☐ Yes ☐ No

- 8) Has your firm; any of its owners; a subsidiary or corporate parent; or any officer, director, or partner thereof, been convicted of violating Section 133.03 Wisconsin Statutes (Unlawful Contracts: Conspiracies) in the last ten (10) years?

☐ Yes ☐ No

COMMITMENT TO SAFETY

A safe work environment is always the top priority of the District, and this priority extends to all contractors and subcontractors on work of any capacity. **Please attach a description of your company's commitment to safety** (including but not limited to safety programs, safety personnel, and leadership commitment)

BONDING RESPONSIBILITY

Current Bonding Company

Bonding Company Name: _____

Mailing Address: _____

Telephone: _____ E-Mail: _____

Firm's current performance and payment bond limit for a single job: _____

Firm's current performance and payment bond limit for aggregate jobs: _____

CONTRACTOR'S FINANCIAL STATEMENT

- 1) Attach a bank letter, no later than the previous calendar year, indicating credit available.
- 2) Attach a dated, recent financial statement, no later than the previous calendar year, showing breakdown of your firm's assets, liabilities, and net worth.

AFFIDAVIT

I certify that all above statements and attachments hereto are true and correct and are made on behalf of

Firm Name

Officer/Owner Name

Signature

Title

Sworn and Subscribed to before me this ____ day of _____, 20__.

Notary Public.

My commission expires _____.